
CEBU PARK
RESIDENCES

DELIVERABLE SPECIFICATIONS

Tiles	60 x 60cm Ceramic Tiles for Living Area
	30 x 60cm Ceramic Wall and Floor Tiles for Toilet and Bath
	30 x 30cm Mosaic Accent Tiles for Shower Area
Kitchen, Wardrobe Furniture	3/4" Thick Marine Plywood in High Pressure Laminate Finish
Kitchen Countertop	3/4" Thick "Black Impala Granite"
Bathroom Fixtures	Lavatory and Water Closet
	Shower set, Lavatory Faucet and Kitchen Gooseneck

STUDIO 21.25SQM.

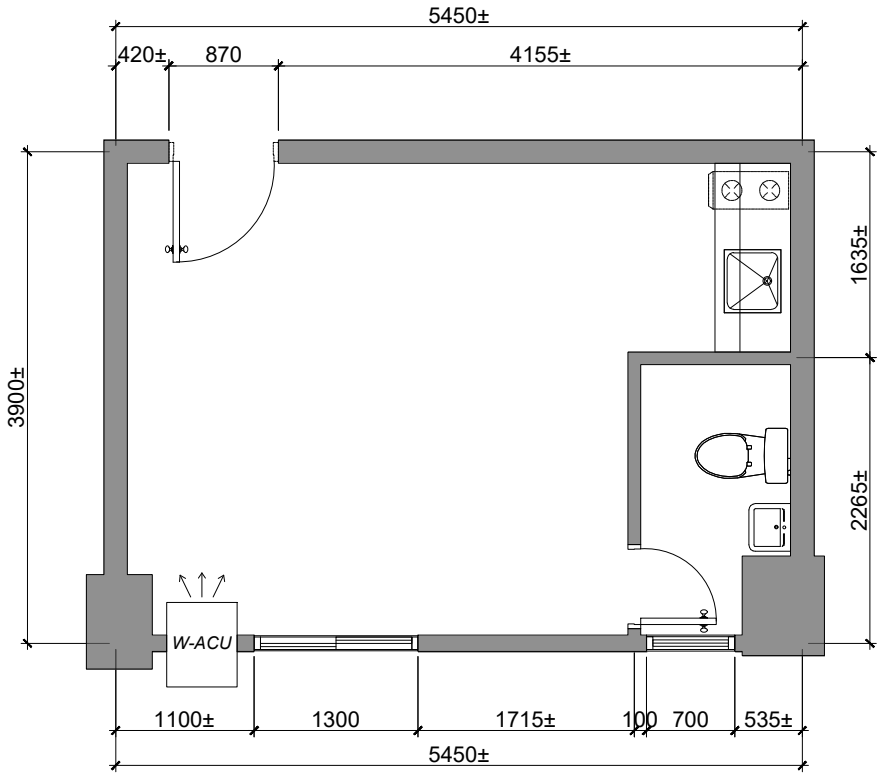

SECOND FLOOR UNIT 2K
SCALE: 1:60M

JECO DEVELOPMENT CORPORATION	HYDE TOWER / UNIT - 2K PROJECT NAME ADD : CEBU PARK RESIDENCES, PRES. MAGSAYSAY EXT. MABOLO, CEBU CITY.	CLIENT/OWNER ADD :	FLOOR PLAN	THIS DRAWING IS ISSUED FOR: ■ AS-BUILT ☐ ESTIMATE ☐ BIDDING ☐ FABRICATION ☐ BUILDING PERMIT ☐ OWNER'S APPROVAL ☐ CONSTRUCTION ☐ PRESENTATION CHECKED BY: DATE: SEPT. 21, 2022	SHEET NO. A 1